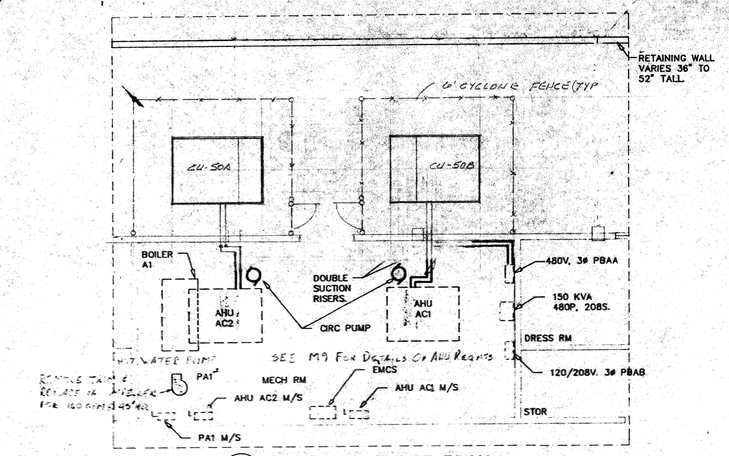

1/M1 ENLARGED FLOOR PLAN
1/8" = 1'-0"

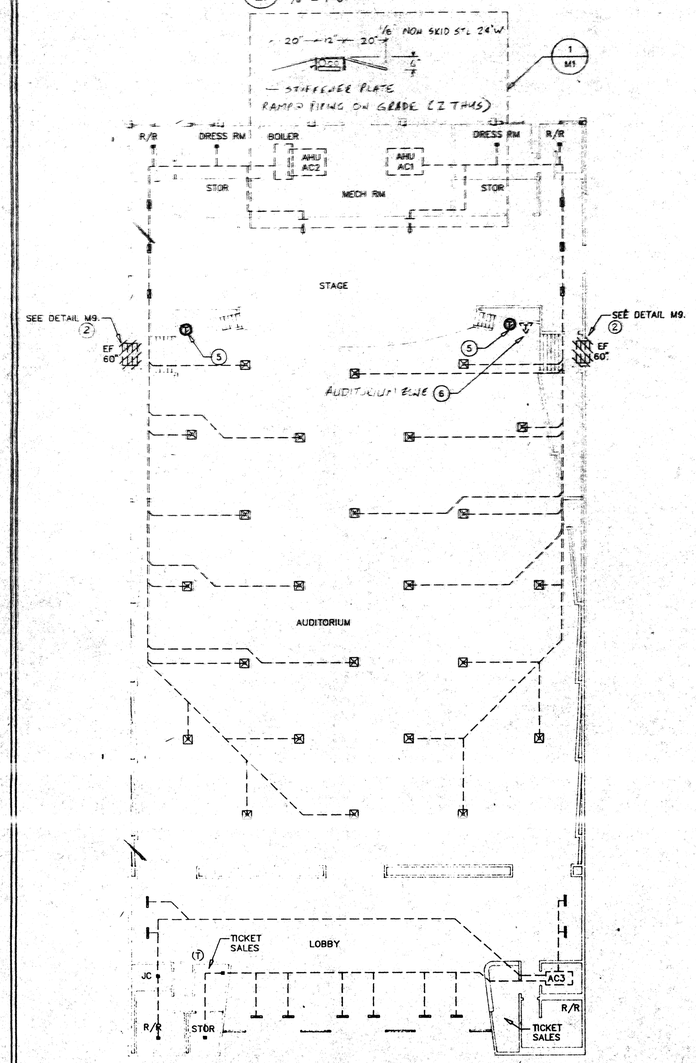

AUDITORIUM FLOOR PLAN
1/16" = 1'-0"

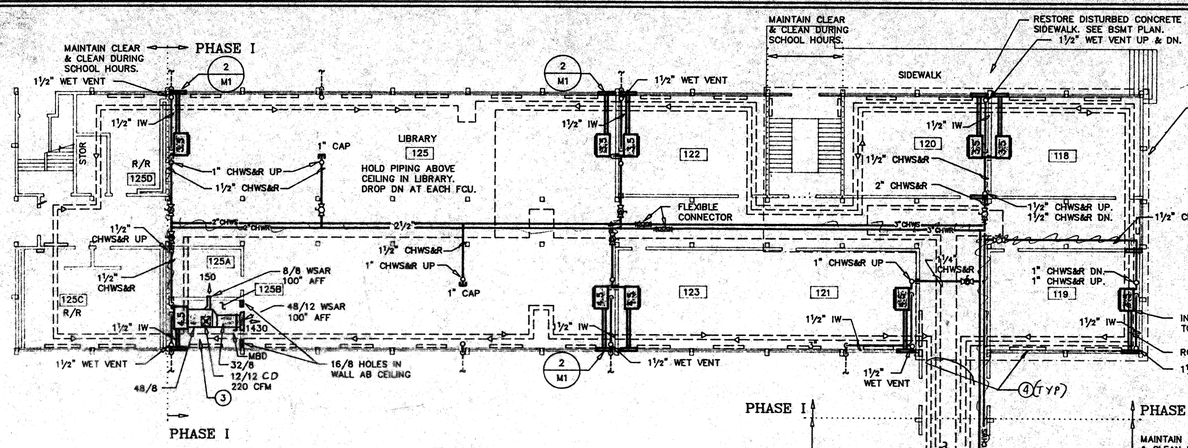

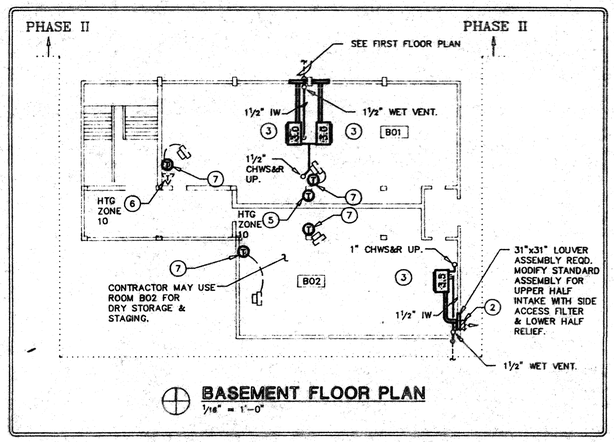

BASEMENT FLOOR PLAN
1/16" = 1'-0"

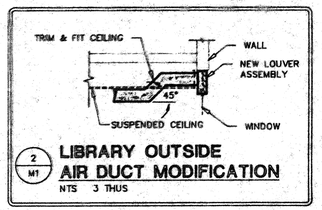

2/M1 LIBRARY OUTSIDE AIR DUCT MODIFICATION
NTS 3 THUS

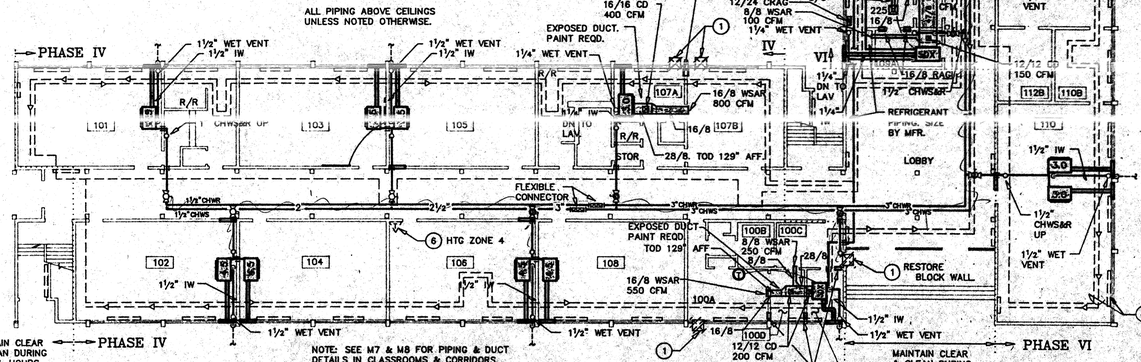

FIRST FLOOR PLAN
1/16" = 1'-0"

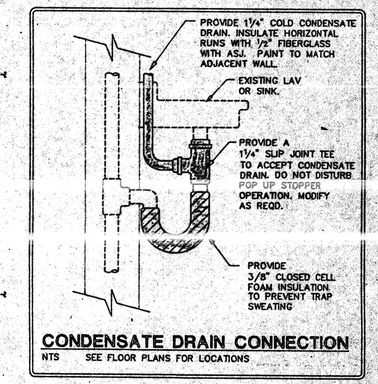

CONDENSATE DRAIN CONNECTION
NTS SEE FLOOR PLANS FOR LOCATIONS

AS BUILT DRAWING Nov 30, 1992

MEDIAC ENGINEERING
NEW HORIZON HEIGHTS ENERGY CONSERVATION
2500 CROCKETT 200 KEMPER, TX. 3615-4564

SHERWOOD JUNIOR HIGH
AIR CONDITIONING RENOVATIONS

REVISIONS

PROJECT NO. 91070

DATE 08 NOV 91

DRAWN LMP CHECKED RCH

SHEET TITLE. AUDITORIUM AND FIRST FLOOR CLASSROOMS

SHEET NO. M1

OF